


CONSTRUCTION LEGEND

- TERRACE NON-PAVED AREA
- TERRACE PLANTING AREA
- GRAVEL AREA
- CONCRETE PAVERS
- REMOVABLE WALK-OFF MAT
- FULL HEIGHT INTERIOR GLASS PARTITION
- FULL HEIGHT GIB WALL
- CONCRETE MASONRY UNIT WALL
- UNITIZED CURTAIN WALL SYSTEM
- STOREFRONT SYSTEM
- INTERIOR GLAZED RAILINGS
- EXTERIOR MESH RAILINGS
- EXTERIOR METAL PICKET RAILINGS
- LOADING DOCK COOLING DOOR
- METAL FRAMED PICKET LIGHT SYSTEM
- PHOTOVOLTAIC ROOF PANELS
- ROOF DRAIN AND OVERFLOW DRAIN

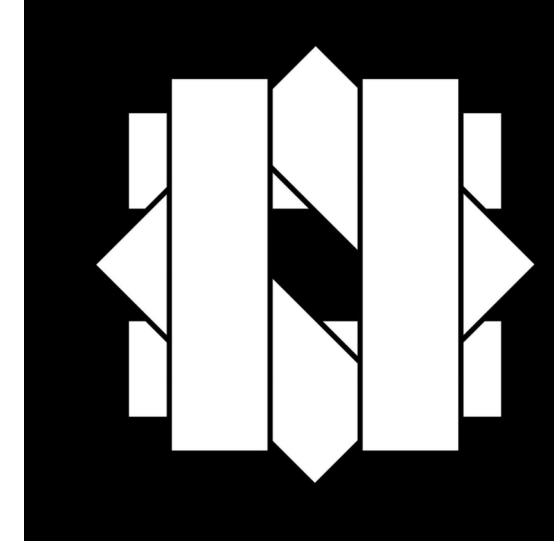

ROBERT DAY SCIENCES CENTER

CLAREMONT MCKENNA COLLEGE
 500 NORTH STREET
 CLAREMONT, CA 91711 USA

CLIENT
 CLAREMONT MCKENNA COLLEGE
 500 NORTH STREET
 CLAREMONT, CA 91711 USA

ARCHITECT
BIG
 STRUCTURAL ENGINEER

MECHANICAL, ELECTRICAL, PLUMBING ENGINEER
 DESIGN PARTNER CONSULTANT

ELECTRICAL ENGINEER
 DESIGN PARTNER CONSULTANT

MEP LEAD CONSULTANT
 WSP USA

LAB PLANNING CONSULTANT
 JACOBS

MECHANICAL, ELECTRICAL, PLUMBING ENGINEER
 DESIGN PARTNER CONSULTANT

LEARNING DESIGN CONSULTANT
 KOM ARCHITECTURAL LIGHTING

MECHANICAL, ELECTRICAL, PLUMBING ENGINEER
 DESIGN PARTNER CONSULTANT

MECHANICAL, ELECTRICAL, PLUMBING ENGINEER
 DESIGN PARTNER CONSULTANT

1. FOR DETAILED TERRACE AND SITE LANDSCAPE PLANS REFER TO LANDSCAPE DRAWINGS.
2. ALL VISIBLE STRUCTURAL STEEL FRAMING MEMBERS TO BE FIREPROOFED WITH INTUMESCENT PAINT (ES REPORT NO. 5078) OR ENCASED IN CONCRETE AS REQUIRED FOR TYPE I-B CONSTRUCTION.
3. SKYLIGHT AT ROOF LEVEL SIZED TO BE LESS THAN 10% OF ROOF AREA TO COMPLY WITH ENERGY REQUIREMENTS. ACTUAL AREA AS SHOWN IN PLANS IS 3.0% OF ROOF AREA.
4. ALL AREAS AT LOW CLEARANCE ZONES LESS THAN 8' AND FLOOR-HEIGHT TRANSITIONS OF LESS THAN 30" TO BE PROVIDED WITH CANE RAILS FOR CANE DETECTION. REFER TO SHEET A-140 FOR CANE RAIL DETAILS. CANE RAILS TO BE CD-01 TYPICAL, UNLESS OTHERWISE NOTED AS CD-04, FE-01 OR FE-02.
5. SEE SHEET A-375 FOR TYPICAL ENTRY WALK OFF MAT PLANS AND DETAILS.
6. ALL CLASSROOM/STRUCTIONAL ASSEMBLY SPACES TO BE PROVIDED WITH A PERMANENTLY INSTALLED ASSISTIVE LISTENING SYSTEM. MINIMUM NUMBER OF RECEIVERS TO BE PROVIDED SHALL BE 4% OF THE TOTAL NUMBER OF SEATS PER 2019 CBC 11B-219.3. REFER TO A-460 FOR LARGE SEMINAR ROOM AND FOR SEATING QUANTITY. NUMBER OF RECEIVERS IN ALL OTHER CLASSROOMS WITH LOOSE SEATING TO BE PROVIDED WITH FF&E DEFERRED SUBMITTAL FOR APPROVAL.
7. WHERE SEATING IS PROVIDED IN ACCESSIBLE SPACES, AT LEAST 1% BUT NOT LESS THAN ONE OF EACH TYPE, MUST BE ACCESSIBLE PER CBC 11B-212.3, 2010 STANDARDS 210.3. A 30"x48" MINIMUM CLEAR FLOOR SPACE, POSITIONED FOR FORWARD APPROACH WITH KNEE AND TOE CLEARANCE IS REQUIRED AT A BANK. CBC 11B-806.2, 2010 STANDARDS 806.2.
8. WHERE SEATING OR STANDING SPACE AT TABLES, COUNTERS OR WORK SURFACES IS PROVIDED IN ACCESSIBLE SPACES, AT LEAST 5 PERCENT OF THE SEATING AND STANDING SPACES, BUT NOT LESS THAN ONE, MUST BE ACCESSIBLE. (CBC 11B-208.1)

NO.	DATE	ISSUE
3	05-29-2024	BULLETIN 4
2	03-23-2023	BULLETIN 2
1	05-19-2023	BULLETIN 1
	03-17-2023	ISSUED FOR CONSTRUCTION
	12-16-2022	50% CONSTRUCTION DOCUMENTS
	09-19-2022	PLAN CHECK SUBMISSION
	05-13-2022	PLAN CHECK / 50% DESIGN DEVELOPMENT
	03-02-2022	100% SCHEMATIC DESIGN
	01-25-2022	50% SCHEMATIC DESIGN


THESE DRAWINGS ARE INSTRUMENTS OF SERVICE AND MAY NOT BE USED FOR OTHER PROJECTS, FOR ADDITIONS TO THIS PROJECT OR COMPLETION OF THIS PROJECT BY OTHERS.

KEYPOINTS

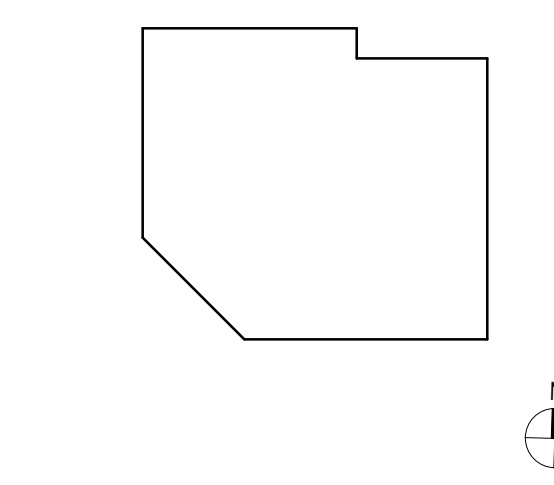


GROUND LEVEL FLOOR PLAN

PROJECT NUMBER: SHEET NUMBER
 2019
 1010
 DATE: As Indicated
 SCALE: As Indicated
 ARCH: E

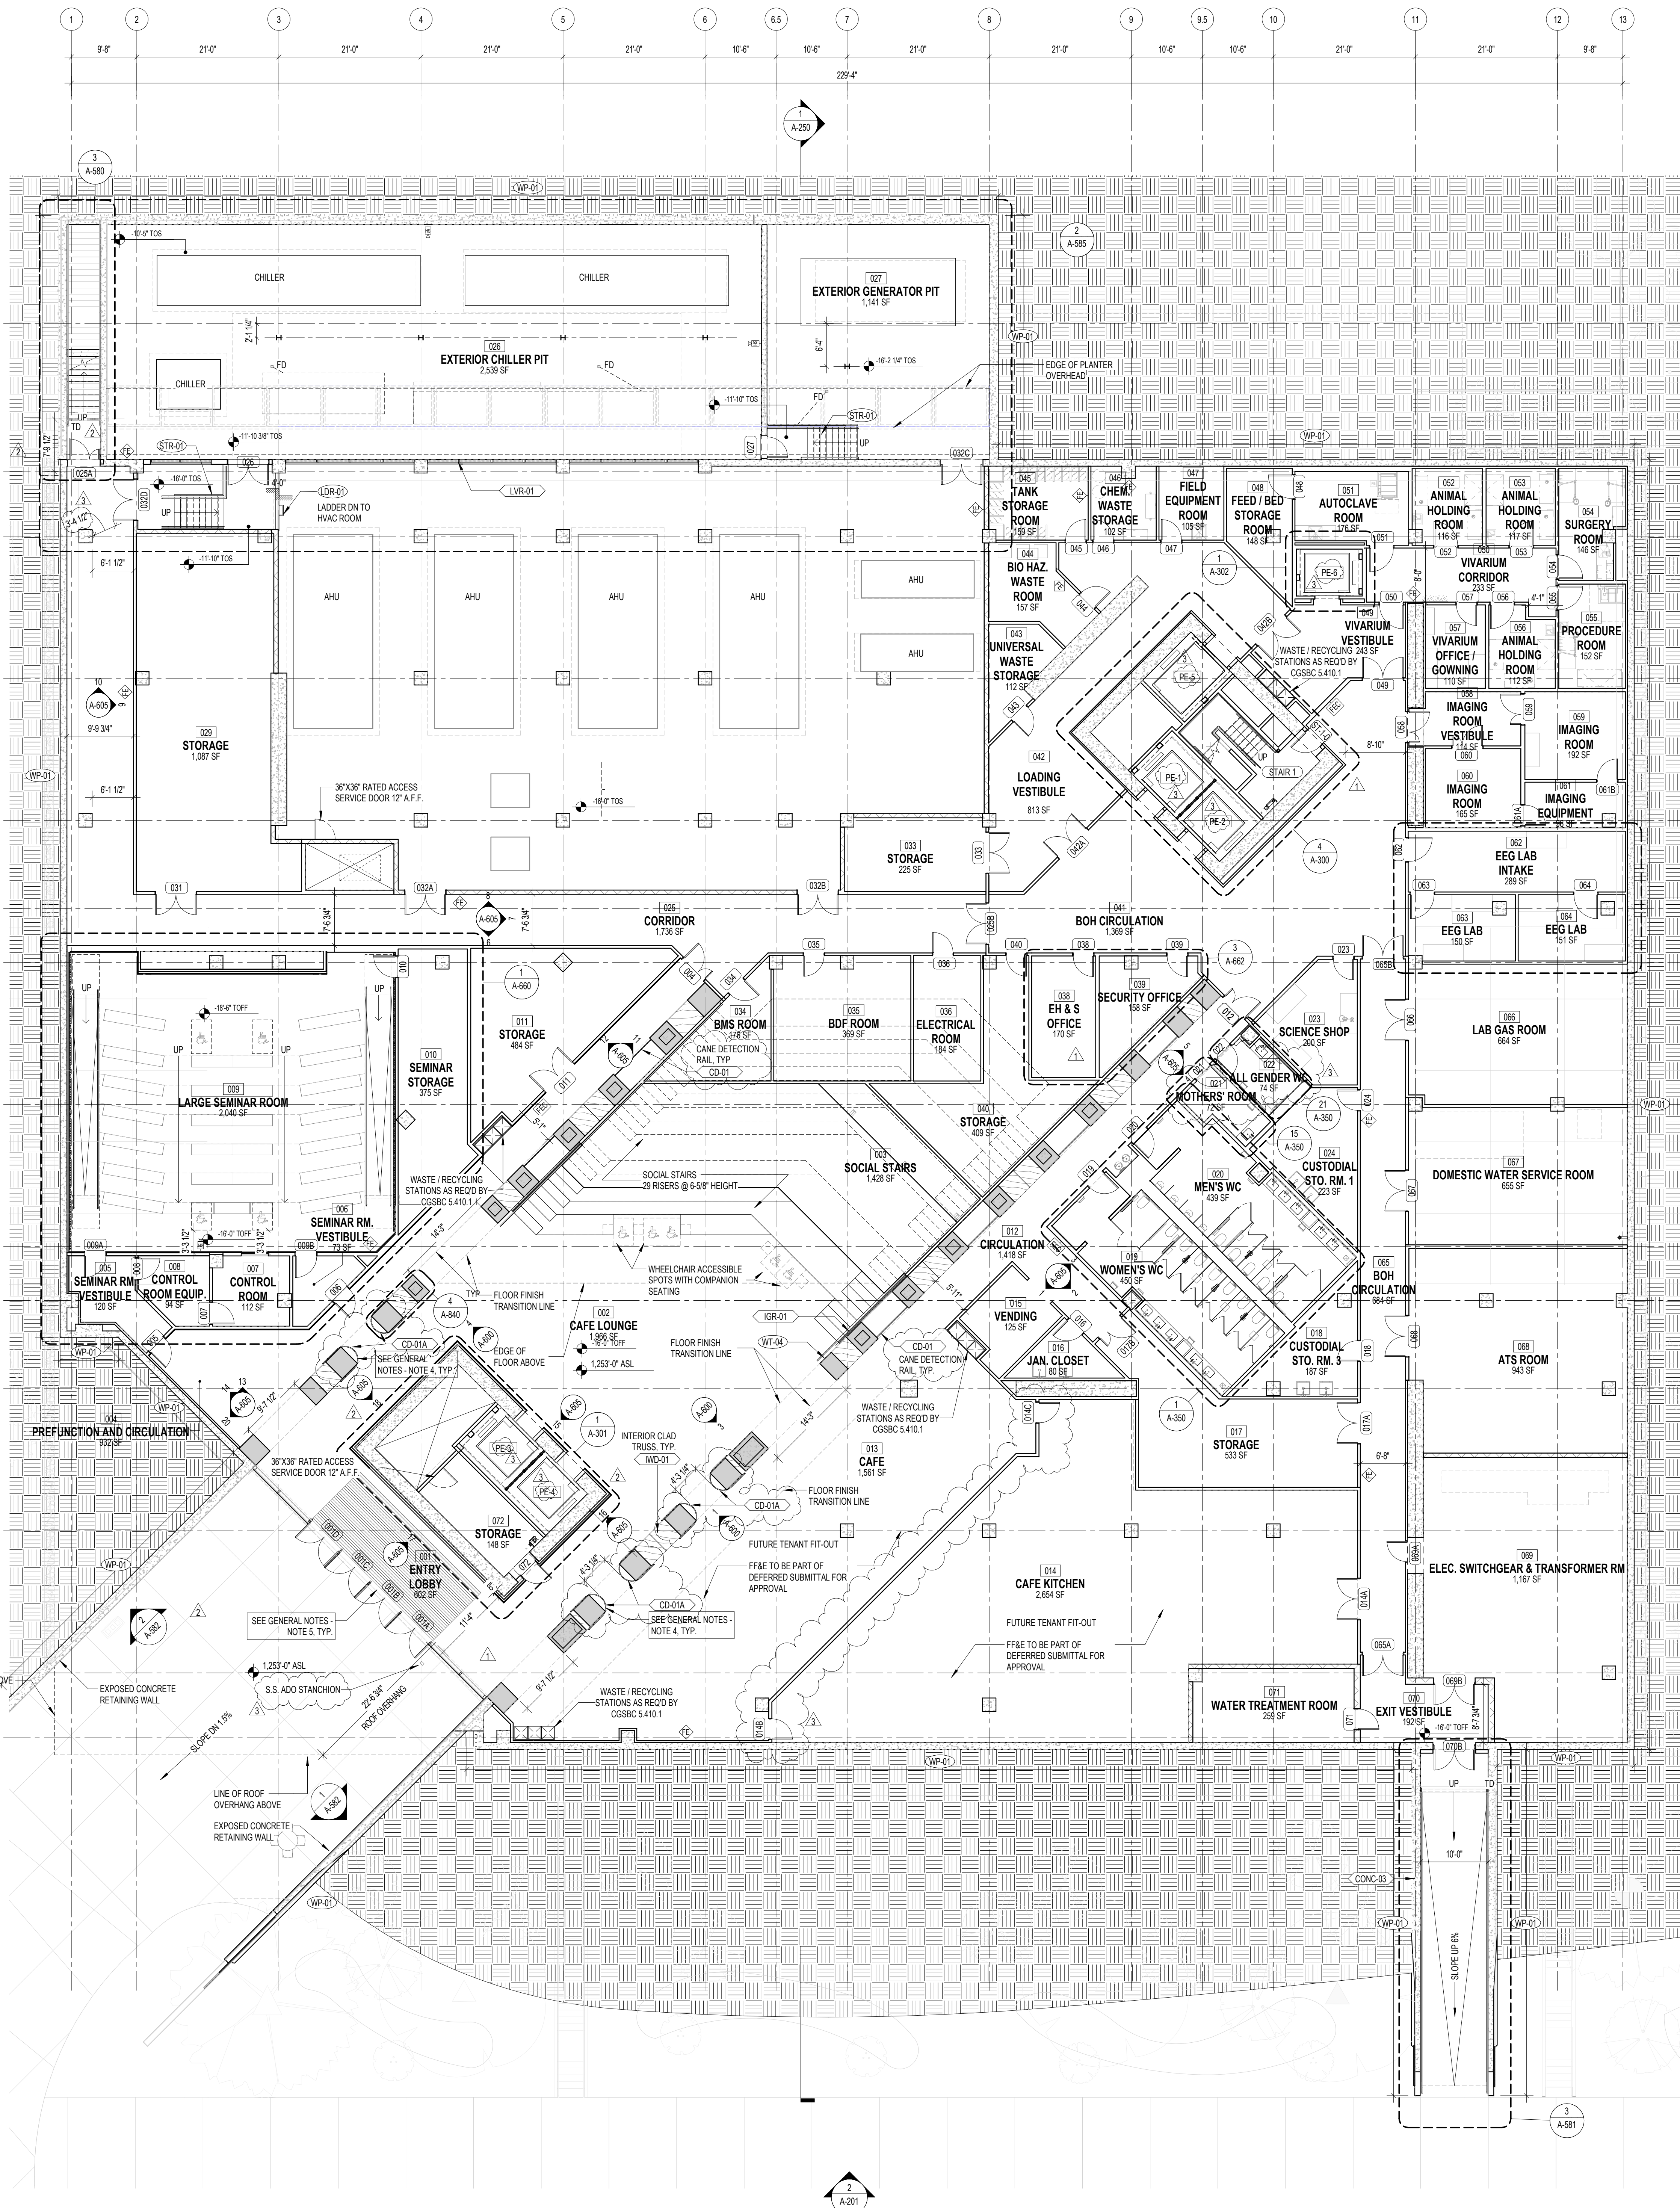

1 GROUND LEVEL FLOOR PLAN
 A-100
 3/2" = 1'-0"

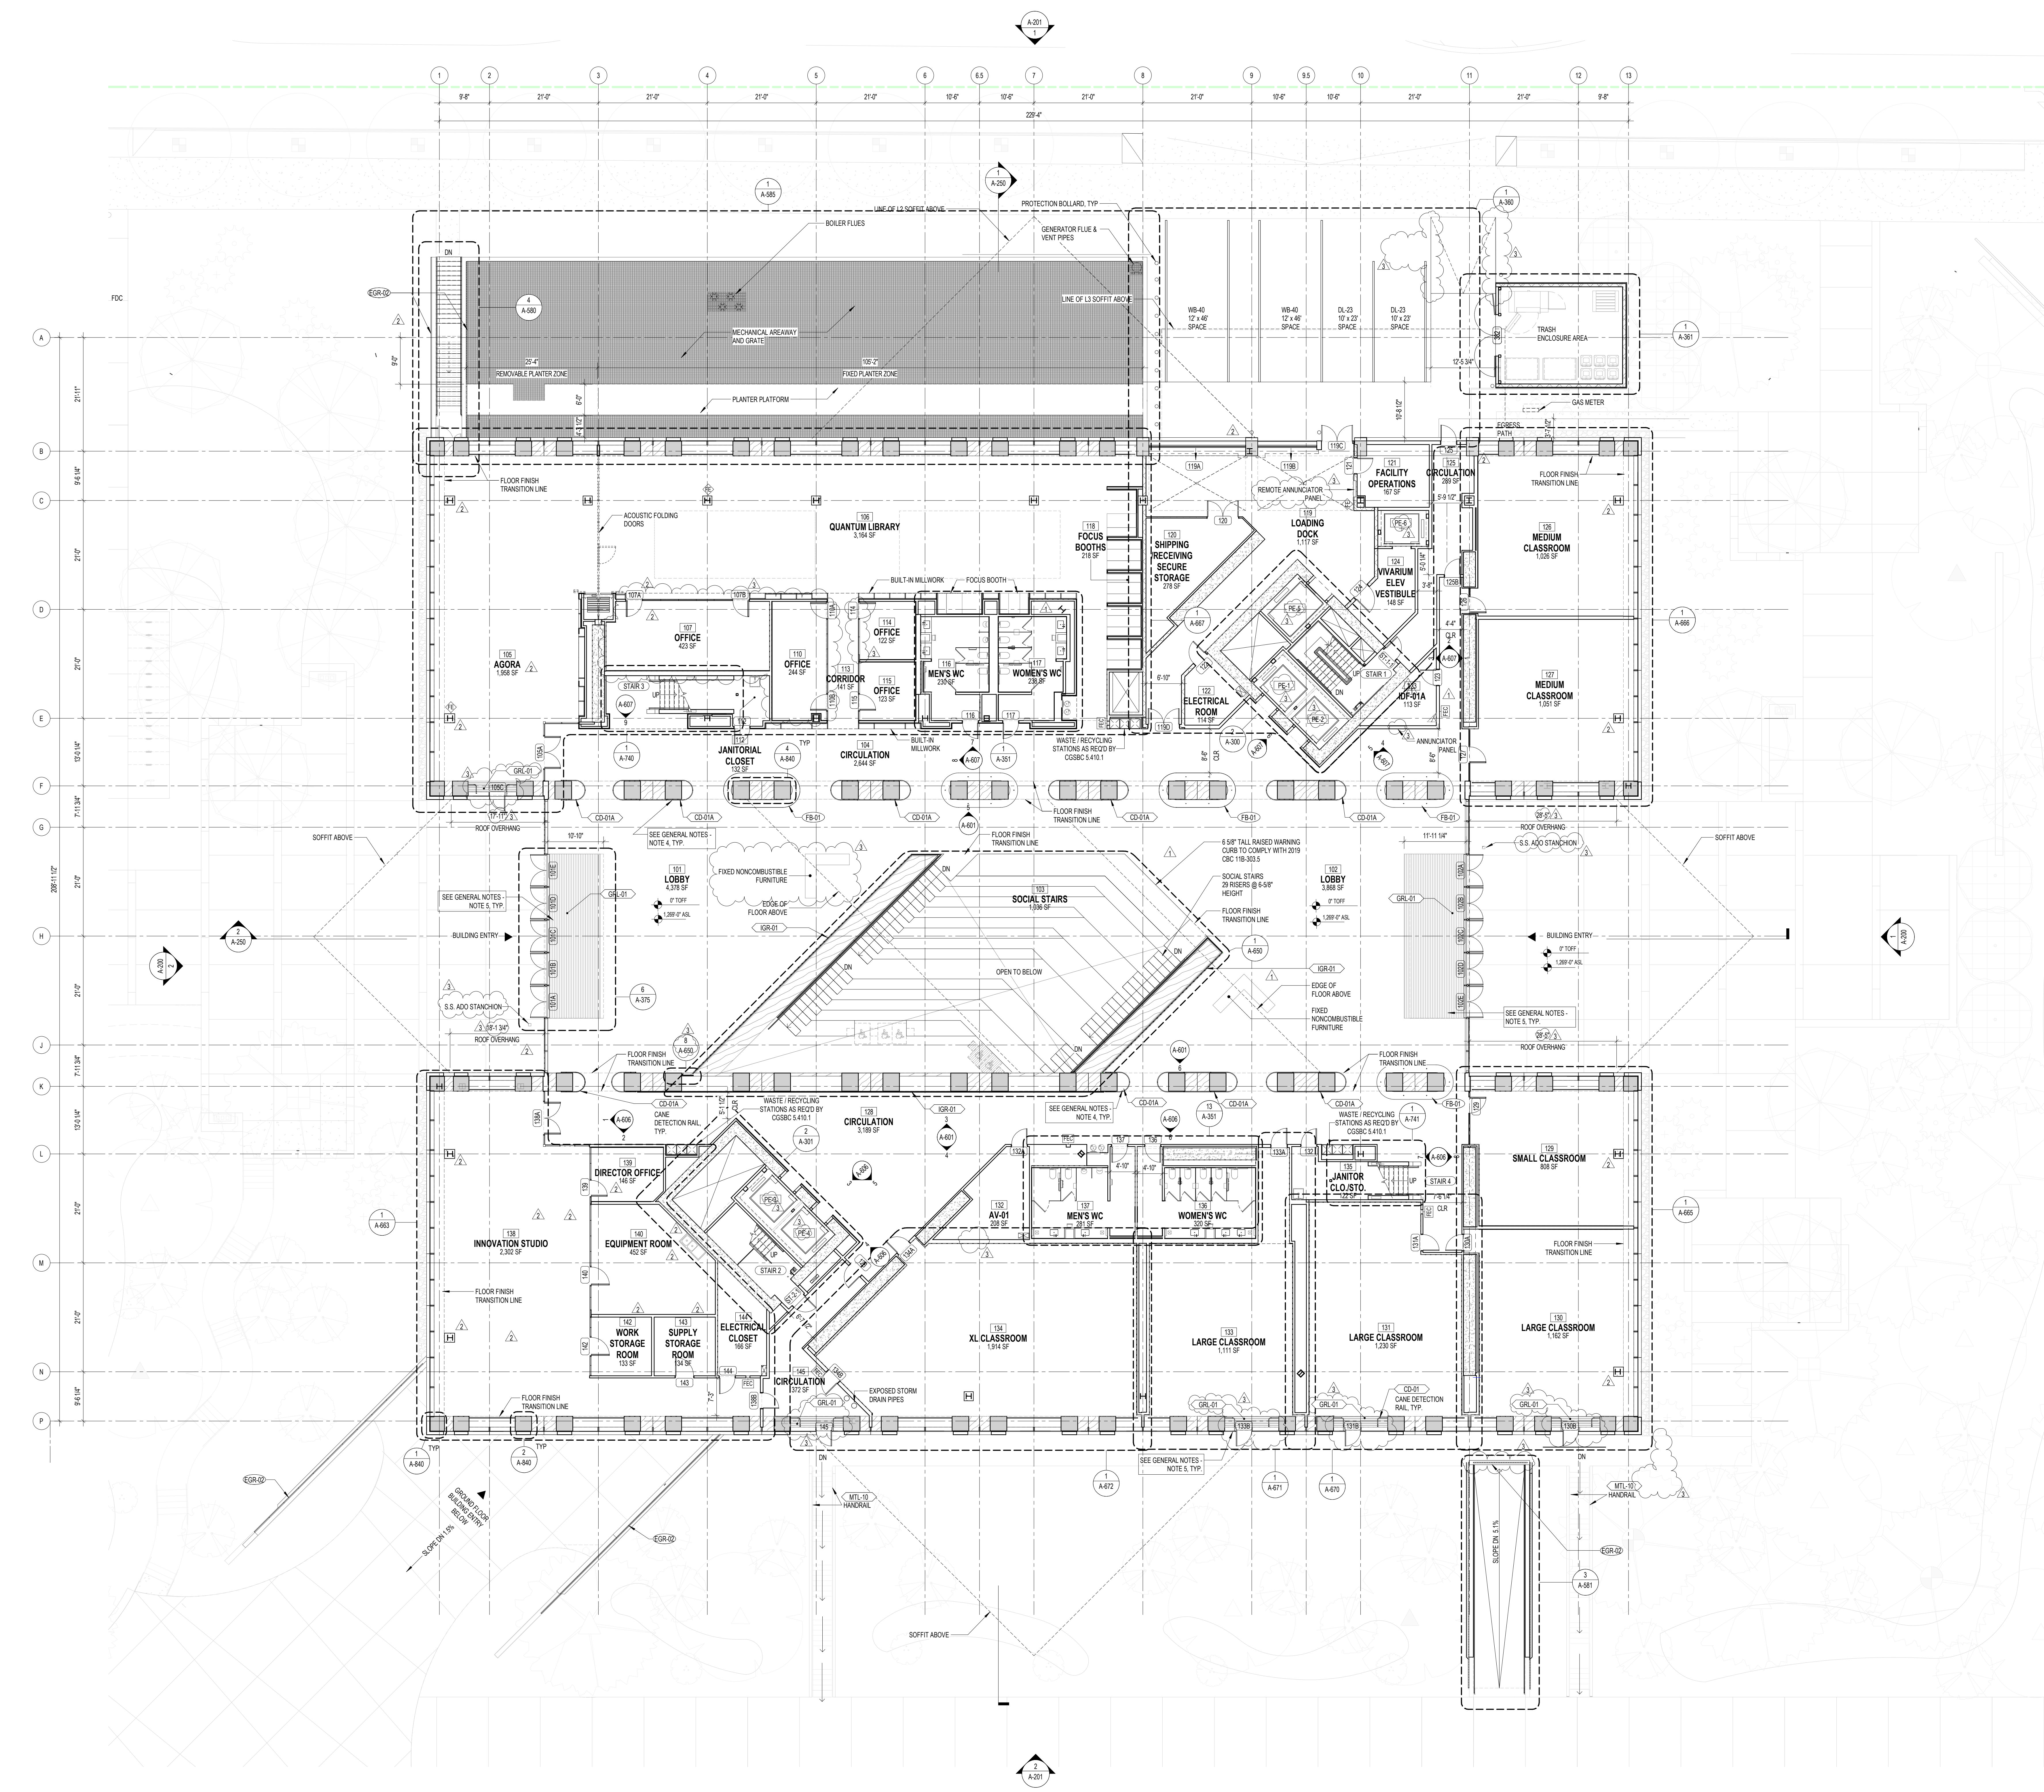

CONSTRUCTION LEGEND

- TERRACE NON-PAVED AREA
- TERRACE PLANTING AREA
- GRAVEL AREA
- CONCRETE PAVERS
- REMOVABLE WALK-OFF MAT
- FULL HEIGHT INTERIOR GLASS PARTITION
- FULL HEIGHT GIB WALL
- CONCRETE MASONRY UNIT WALL
- UNITIZED CURTAIN WALL SYSTEM
- STOREFRONT SYSTEM
- INTERIOR GLAZED RAILINGS
- EXTERIOR MESH RAILINGS
- EXTERIOR METAL POCKET RAILINGS
- LOADING DOCK COOLING DOOR
- METAL FRAMED SKYLIGHT SYSTEM
- PHOTOVOLTAIC ROOF PANELS
- ROOF DRAIN AND OVERFLOW DRAIN



ROBERT DAY SCIENCES CENTER



















GENERAL NOTES

1. FOR DETAILED TERRACE AND SITE LANDSCAPE PLANS REFER TO LANDSCAPE DRAWINGS.
2. ALL VISIBLE STRUCTURAL STEEL MEMBERS TO BE FIREPROTECTED WITH INTUMESCENT PAINT (ES REPORT NO. 5078) OR ENCASED IN CONCRETE AS REQUIRED FOR TYPE 1B CONSTRUCTION.
3. SKYLIGHT AT ROOF LEVEL SIZED TO BE LESS THAN 10% OF ROOF AREA TO COMPLY WITH ENERGY REQUIREMENTS. ACTUAL AREA AS SHOWN IN PLANS IS 3.3% OF ROOF AREA.
4. ALL AREAS AT LOW CLEARANCE ZONES LESS THAN 8' AND FLOOR HEIGHT TRANSITIONS OF LESS THAN 30" TO BE PROVIDED WITH CANE RAILS FOR CANE DETECTION. REFER TO SHEET A-125 FOR CANE RAIL DETAILS. CANE RAILS TO BE CD-01 TYPICAL, UNLESS OTHERWISE NOTED AS CD-02A, B, OR B-01A.
5. SEE SHEET A-375 FOR TYPICAL ENTRY WALK-OFF MAT PLANS AND DETAILS.
6. ALL CLASSROOMS/INSTRUCTIONAL ASSEMBLY SPACES TO BE PROVIDED WITH A PERMANENTLY INSTALLED ASSISTIVE LISTENING SYSTEM. MINIMUM NUMBER OF RECEIVERS TO BE PROVIDED SHALL BE 4% OF THE TOTAL NUMBER OF SEATS PER 2019 CBC 18-219.3. REFER TO A-376 FOR LARGE SEMINAR ROOM ROOM FOR DEVICE QUANTITY. NUMBER OF RECEIVERS IN ALL OTHER CLASSROOMS WITH LOOSE SEATING TO BE PROVIDED WITH FIVE SEPARATE SUBMITTA FOR APPROVAL.
7. WHERE SEATING IS PROVIDED IN ACCESSIBLE SPACES AT LEAST 1% BUT NOT LESS THAN ONE OF EACH TYPE, MUST BE ACCESSIBLE PER CBC 18-212.3, 2010 STANDARDS 212.3. A 30"x48" MINIMUM CLEAR FLOOR SPACE, POSITIONED FOR FORWARD APPROACH WITH KNEE AND TOE CLEARANCE IS REQUIRED AT A BUNK. (CBC 18-206.2, 2010 STANDARDS 206.2).
8. WHERE SEATING OR STANDING SPACE AT TABLES, COUNTERS OR WORK SURFACES IS PROVIDED IN ACCESSIBLE SPACES AT LEAST 5% PERCENT OF THE SEATING AND STANDING SPACES, BUT NOT LESS THAN ONE, MUST BE ACCESSIBLE. (CBC 18-206.1)


NO.	DATE	ISSUE
1	05-29-2024	BULLETIN 4
2	05-23-2023	BULLETIN 2
3	05-19-2023	BULLETIN 1
4	03-17-2023	ISSUED FOR CONSTRUCTION
5	12-16-2022	50% CONSTRUCTION DOCUMENTS
6	09-19-2022	PLAN CHECK SUBMISSION
7	05-19-2022	PLAN CHECK / 50% DESIGN DEVELOPMENT
8	03-02-2022	100% SCHEMATIC DESIGN
9	01-25-2022	50% SCHEMATIC DESIGN

THESE DRAWINGS ARE INSTRUMENTS OF SERVICE AND MAY NOT BE USED FOR OTHER PROJECTS, FOR ADDITIONS TO THIS PROJECT OR COMPLETION OF THIS PROJECT BY OTHERS.

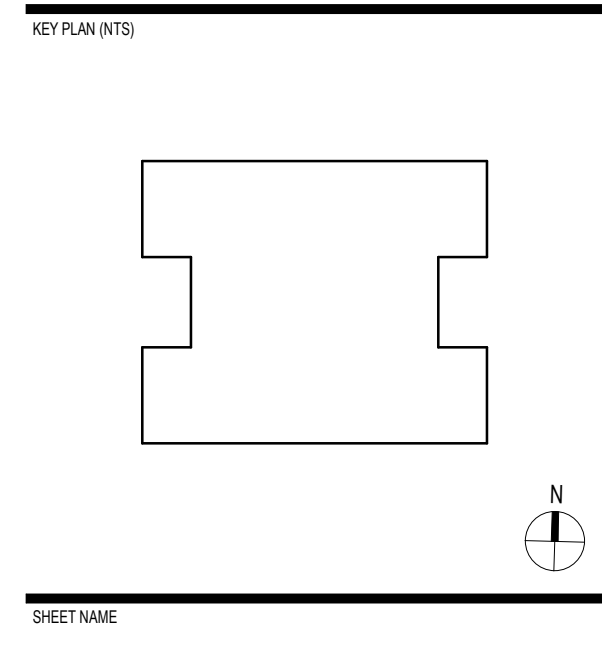

LEVEL 1 FLOOR PLAN

1 LEVEL 1 FLOOR PLAN
 A-101
 3/22" = 1'-0"

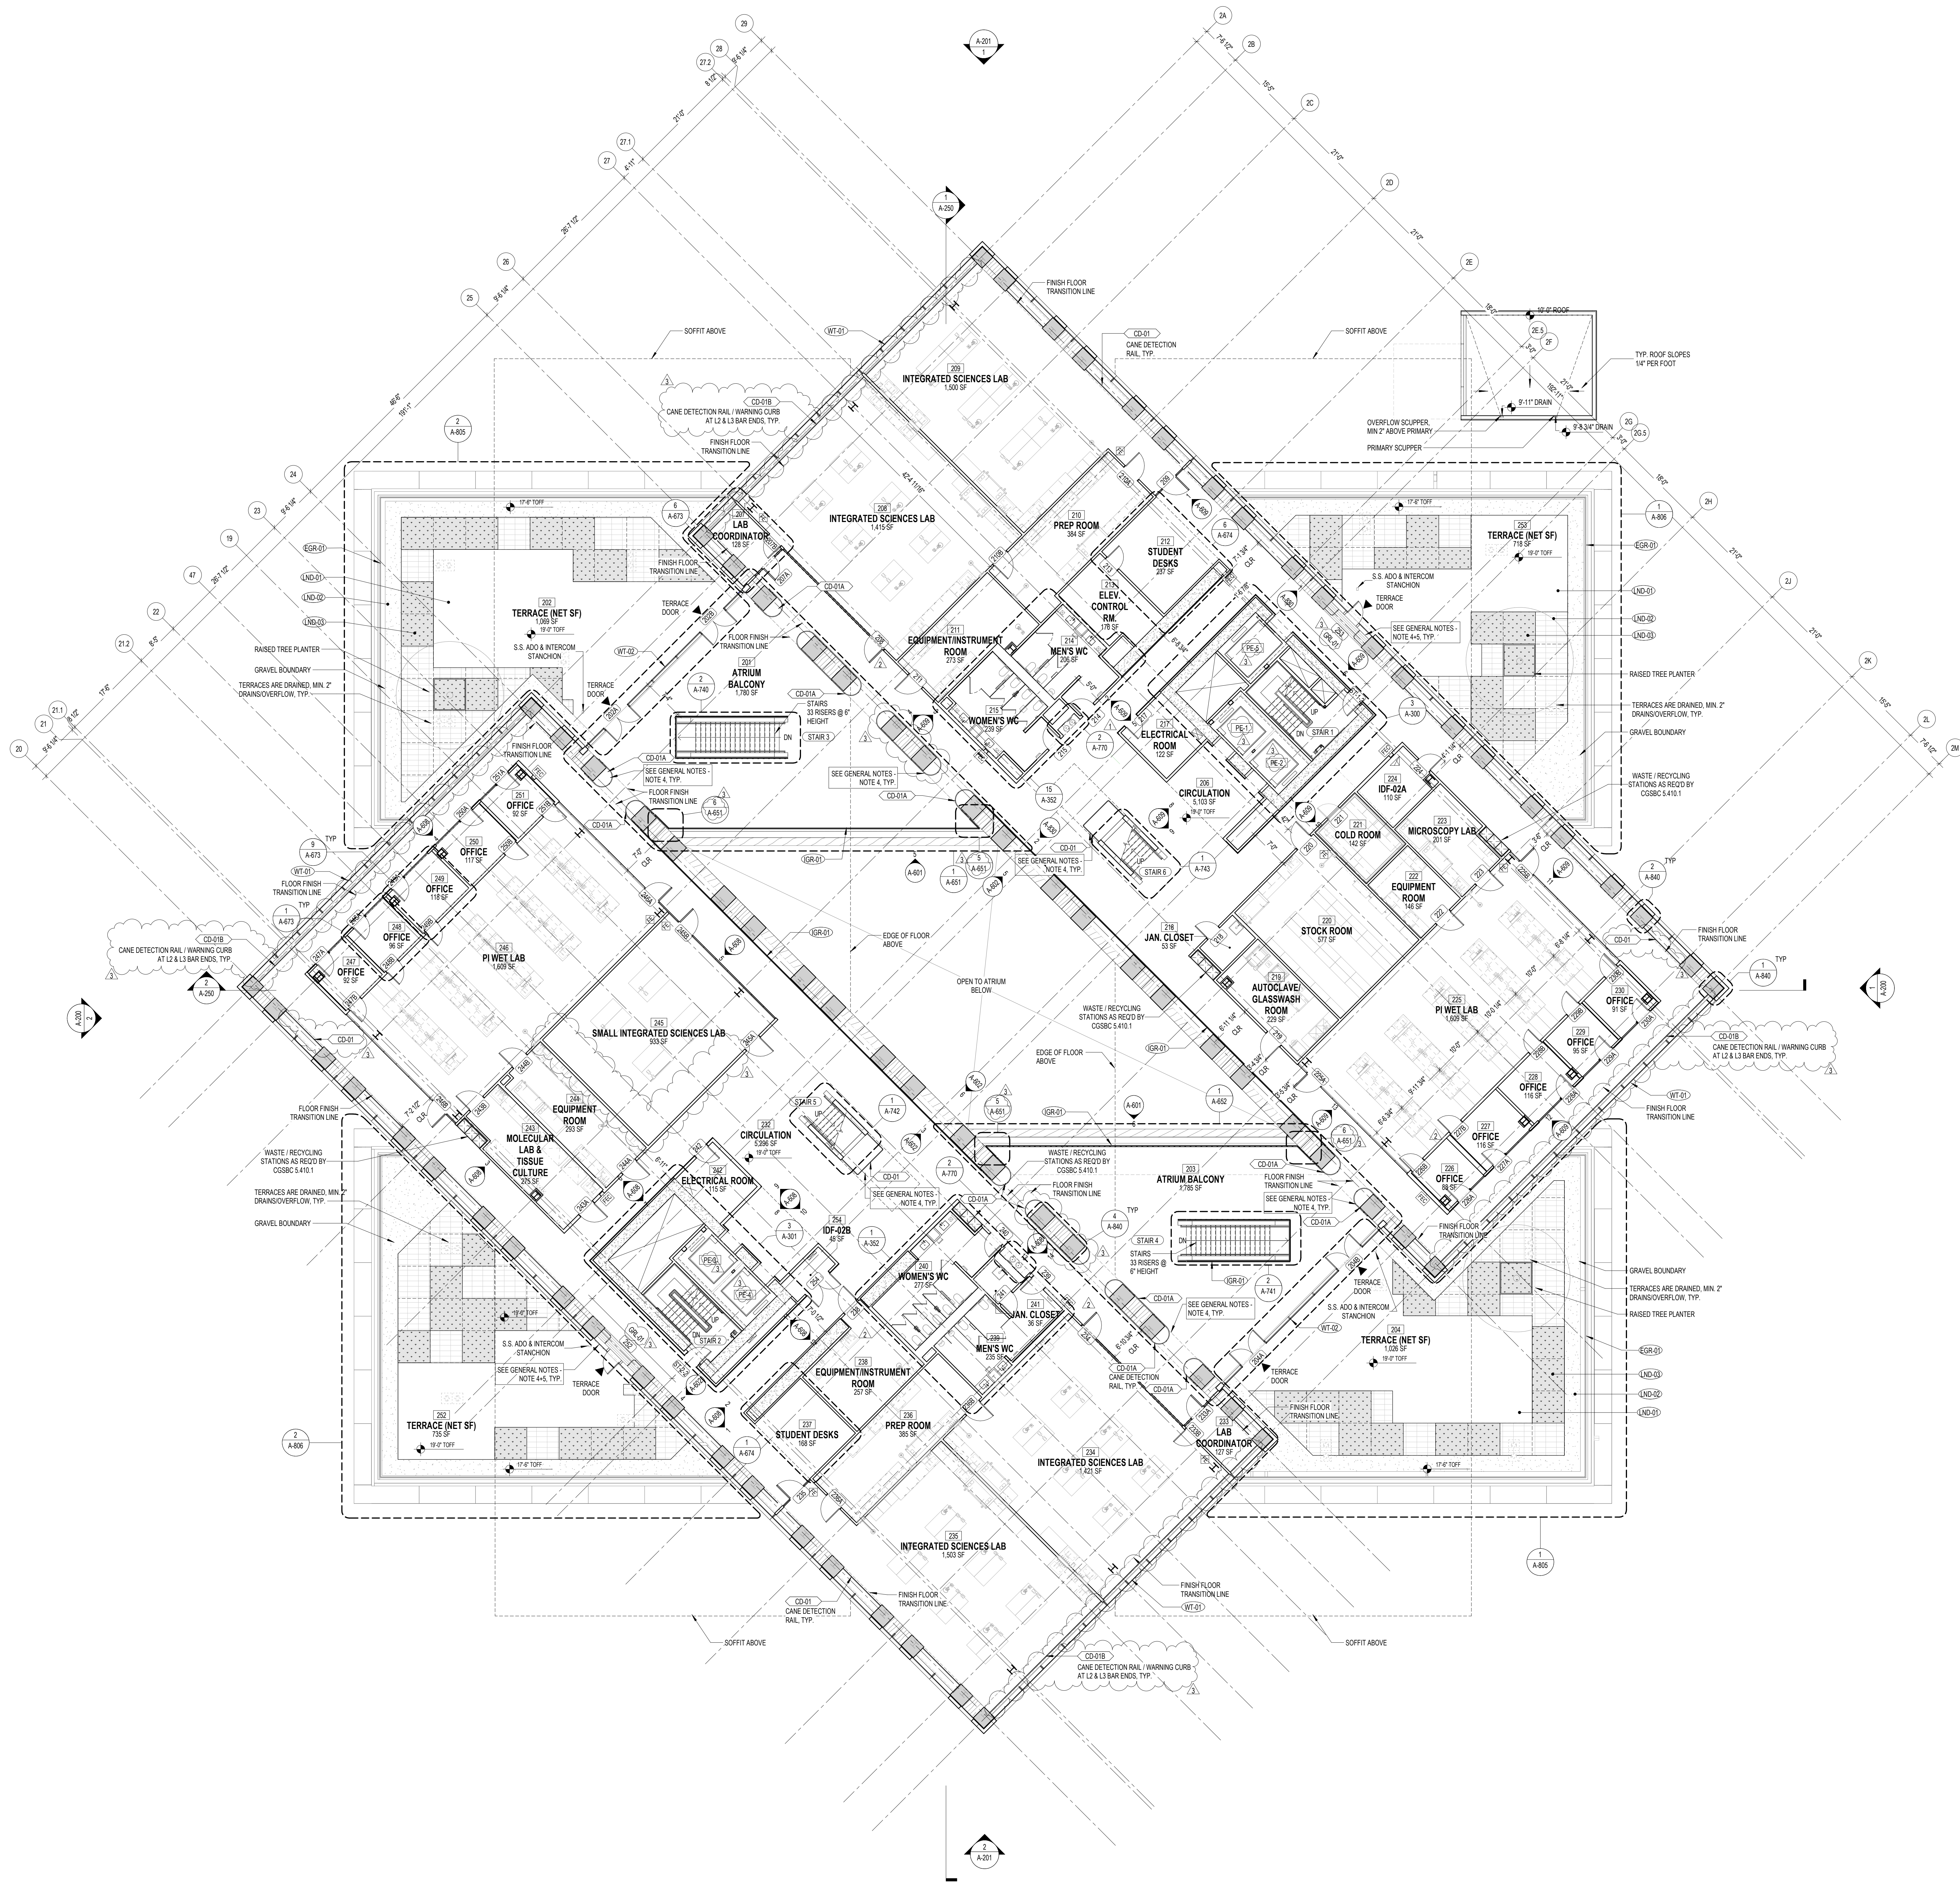


CONSTRUCTION LEGEND

- TERRACE NON-PAVED AREA
- TERRACE PLANTING AREA
- GRAVEL AREA
- CONCRETE PAVERS
- REMOVABLE WALK-OFF MAT
- FULL HEIGHT INTERIOR GLASS PARTITION
- FULL HEIGHT GIB WALL
- CONCRETE MASONRY UNIT WALL
- UNITIZED CURTAIN WALL SYSTEM
- STOREFRONT SYSTEM
- INTERIOR GLAZED RAILINGS
- EXTERIOR MESH RAILINGS
- EXTERIOR METAL PICKET RAILINGS
- LOADING DOCK COILING DOOR
- METAL FRAMED SKYLIGHT SYSTEM
- PHOTOVOLTAIC ROOF PANELS
- ROOF DRAIN AND OVERFLOW DRAIN

GENERAL NOTES

1. FOR DETAILED TERRACE AND SITE LANDSCAPE PLANS REFER TO LANDSCAPE DRAWINGS.
2. ALL VISIBLE STRUCTURAL STEEL FRAMING MEMBERS TO BE FIREPROOFED WITH INTUMESCENT PAINT (ES REPORT NO. 1078) OR ENCASED IN CONCRETE AS REQUIRED FOR TYPE 1B CONSTRUCTION.
3. SKYLIGHT AT ROOF LEVEL, SIZED TO BE LESS THAN 10% OF ROOF AREA TO COMPLY WITH ENERGY REQUIREMENTS. ACTUAL AREA AS SHOWN IN PLANS IS 3.0% OF ROOF AREA.
4. ALL AREAS AT LOW CLEARANCE ZONES LESS THAN 8' AND FLOOR HEIGHT TRANSITIONS OF LESS THAN 30" TO BE PROVIDED WITH CANE RAILS FOR CANE DETECTION. REFER TO SHEET A-163 FOR CANE RAIL DETAILS. CANE RAILS TO BE CD-01A TYPICAL, UNLESS OTHERWISE NOTED AS CD-01A, FB-01 OR FB-01A.
5. SEE SHEET A-375 FOR TYPICAL ENTRY WALK OFF MAT PLANS AND DETAILS.
6. ALL CLASSROOMS/INSTRUCTIONAL ASSEMBLY SPACES TO BE PROVIDED WITH A PERMANENTLY INSTALLED ASSISTIVE LISTENING SYSTEM. MINIMUM NUMBER OF RECEIVERS TO BE PROVIDED SHALL BE 4% OF THE TOTAL NUMBER OF SEATS PER 2010 IBC 11B-219.3. A 30" MINIMUM CLEAR FLOOR SPACE, POSITIONED FOR FORWARD APPROACH WITH KNEE AND TOE CLEARANCE IS REQUIRED AT A SEAT. (IBC 11B-206.2, 2010 STANDARDS 603.2)
7. WHERE SINKS ARE PROVIDED IN ACCESSIBLE SPACES, AT LEAST 5%, BUT NOT LESS THAN ONE OF EACH TYPE, MUST BE ACCESSIBLE PER IBC 11B-203.3, 2010 STANDARDS 312.3. A 30" MINIMUM CLEAR FLOOR SPACE, POSITIONED FOR FORWARD APPROACH WITH KNEE AND TOE CLEARANCE IS REQUIRED AT A SINK. (IBC 11B-206.2, 2010 STANDARDS 603.2)
8. WHERE SEATING OR STANDING SPACE AT TABLES, COUNTERS OR WORK SURFACES IS PROVIDED IN ACCESSIBLE SPACES, AT LEAST 5% PERCENT OF THE SEATING AND STANDING SPACES, BUT NOT LESS THAN ONE, MUST BE ACCESSIBLE. (IBC 11B-206.1)

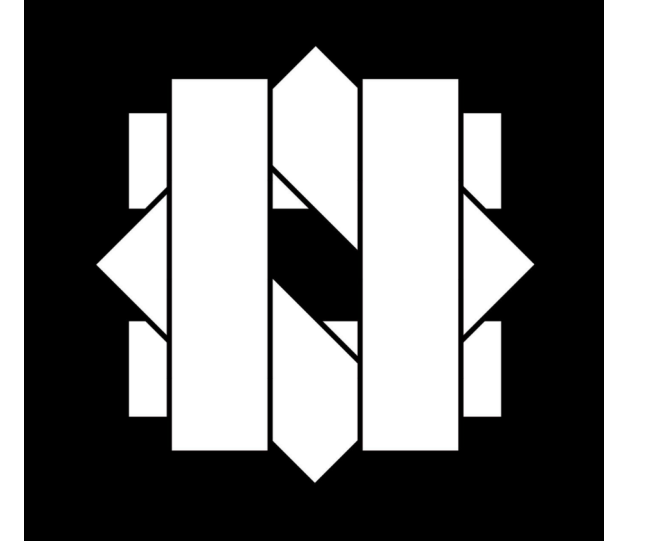

ROBERT DAY SCIENCES CENTER

CLAREMONT MCKENNA COLLEGE
 100 W. CLAREMONT BOULEVARD
 CLAREMONT, CA 91711 USA
 CLIENT
 CLAREMONT MCKENNA COLLEGE
 100 W. CLAREMONT BOULEVARD
 CLAREMONT, CA 91711 USA
 PROJECT NO. 2015-001


















NO.	DATE	ISSUE
1	05.29.2024	BULLETIN 4
2	05.23.2023	BULLETIN 2
1	05.19.2023	BULLETIN 1
1	03.17.2023	ISSUES FOR CONSTRUCTION
1	12.16.2022	50% CONSTRUCTION DOCUMENTS
1	09.19.2022	PLAN CHECK SUBMISSION
1	05.13.2022	PLAN CHECK / 50% DESIGN DEVELOPMENT
1	03.02.2022	100% SCHEMATIC DESIGN
1	01.20.2022	50% SCHEMATIC DESIGN

THESE DRAWINGS ARE INSTRUMENTS OF SERVICE AND MAY NOT BE USED FOR OTHER PROJECTS, FOR ADDITIONS TO THIS PROJECT OR COMPLETION OF THIS PROJECT BY OTHERS.

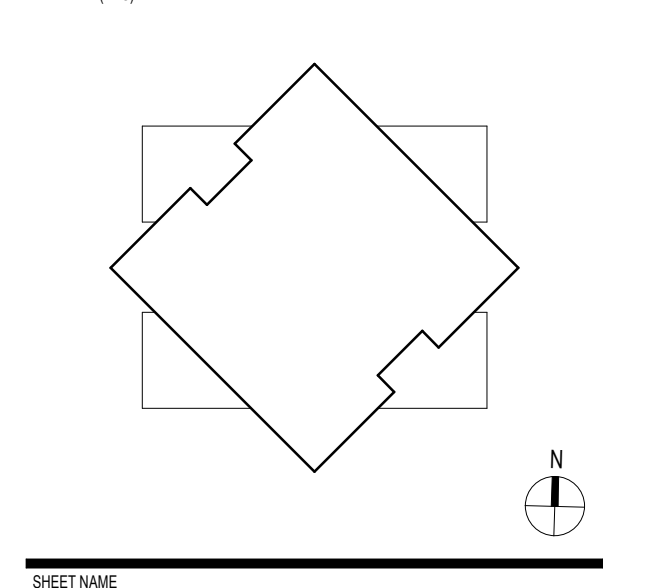


LEVEL 2 FLOOR PLAN

PROJECT NUMBER: SHEET NUMBER
 2015-001
 1010
 DATE: As Indicated
 SCALE: As Indicated
 ARCH: E

CONSTRUCTION LEGEND

- TERRACE NON-PAVED AREA
- TERRACE PLANTING AREA
- GRAVEL AREA
- CONCRETE PAVERS
- REMOVEABLE WALK-OFF MAT
- FULL HEIGHT INTERIOR GLASS PARTITION
- FULL HEIGHT GIB WALL
- CONCRETE MASONRY UNIT WALL
- UNITIZED CURTAIN WALL SYSTEM
- STOREFRONT SYSTEM
- INTERIOR GLAZED RAILINGS
- EXTERIOR MESH RAILINGS
- EXTERIOR METAL PICKET RAILINGS
- LOADING DOCK COOLING DOOR
- METAL FRAMED PICKET SYSTEM
- PHOTOVOLTAIC ROOF PANELS
- ROOF DRAIN AND OVERFLOW DRAIN

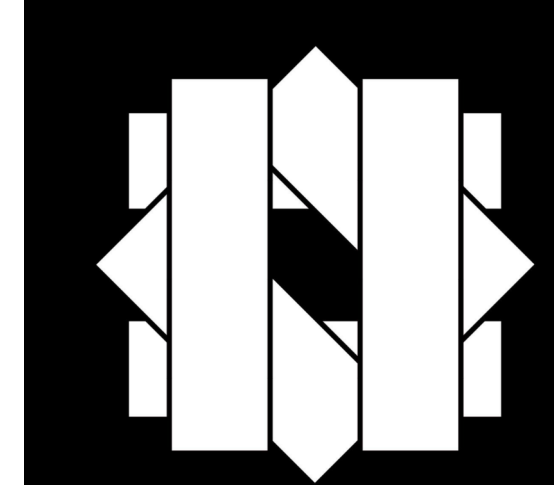

ROBERT DAY SCIENCES CENTER



































ISSUE TRACKING

NO.	DATE	ISSUE
1	05-29-2024	BULLETIN 4
2	10-23-2023	BULLETIN 2
3	03-17-2023	ISSUED FOR CONSTRUCTION
4	02-16-2022	50% CONSTRUCTION DOCUMENTS
5	09-18-2022	PLAN CHECK SUBMISSION
6	05-13-2022	PLAN CHECK / 50% DESIGN DEVELOPMENT
7	03-02-2022	100% SCHEMATIC DESIGN
8	01-25-2022	50% SCHEMATIC DESIGN


REVISIONS

NO.	DATE	ISSUE
1	05-29-2024	BULLETIN 4
2	10-23-2023	BULLETIN 2
3	03-17-2023	ISSUED FOR CONSTRUCTION
4	02-16-2022	50% CONSTRUCTION DOCUMENTS
5	09-18-2022	PLAN CHECK SUBMISSION
6	05-13-2022	PLAN CHECK / 50% DESIGN DEVELOPMENT
7	03-02-2022	100% SCHEMATIC DESIGN
8	01-25-2022	50% SCHEMATIC DESIGN

THESE DRAWINGS ARE INSTRUMENTS OF SERVICE AND MAY NOT BE USED FOR OTHER PROJECTS, FOR ADDITIONS TO THIS PROJECT OR COMPLETION OF THIS PROJECT BY OTHERS.

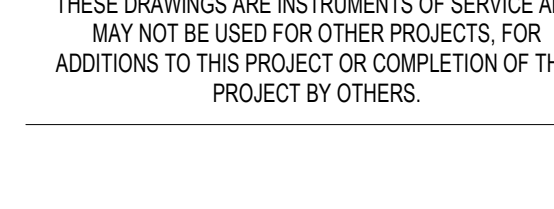

SHEET NAME

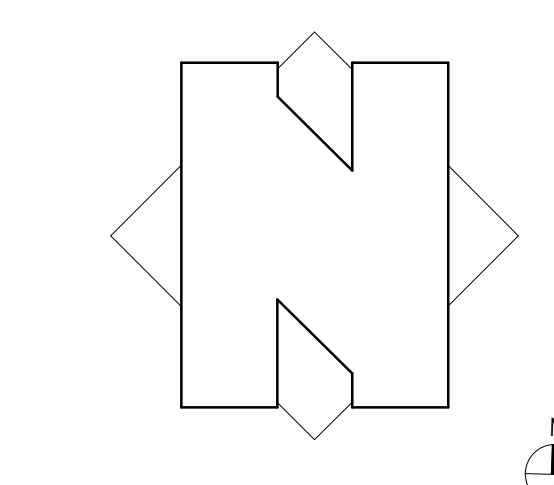

SHEET NUMBER

2019

DATE

As Indicated

SCALE

AS SHOWN














GENERAL NOTES

- FOR DETAILED TERRACE AND SITE LANDSCAPE PLANS REFER TO LANDSCAPE DRAWINGS.
- ALL VISIBLE STRUCTURAL STEEL FRAMING MEMBERS TO BE FIREPROOFED WITH INTUMESCENT PAINT (SEE REPORT NO. 1076) OR ENCASED IN CONCRETE AS REQUIRED FOR TYPE 1B CONSTRUCTION.
- SKYLIGHT AT ROOF LEVEL SIZED TO BE LESS THAN 10% OF ROOF AREA TO COMPLY WITH ENERGY REQUIREMENTS. ACTUAL AREA AS SHOWN IN PLANS IS 3.3% OF ROOF AREA.
- ALL AREAS AT LOW CLEARANCE ZONES LESS THAN 8' AND FLOOR HEIGHT TRANSITIONS OF LESS THAN 30" TO BE PROVIDED WITH CANE RAILS FOR CANE DETECTION. REFER TO SHEET A-165 FOR CANE RAIL DETAILS. CANE RAILS TO BE CD-01 TYPICAL, UNLESS OTHERWISE NOTED AS CD-0A, FB-01 OR FB-0A.
- SEE SHEET A-375 FOR TYPICAL ENTRY WALK OFF MAT PLANS AND DETAILS.
- ALL CLASSROOMS/INSTRUCTIONAL ASSEMBLY SPACES TO BE PROVIDED WITH A PERMANENTLY INSTALLED ASSISTIVE LISTENING SYSTEM. MINIMUM NUMBER OF RECEIVERS TO BE PROVIDED SHALL BE 4% OF THE TOTAL NUMBER OF SEATS PER 2019 IBC 10B-219.3. REFER TO A-650 FOR LARGE SEMINAR ROOM #009 FOR DEVICE QUANTITY. NUMBER OF RECEIVERS IN ALL OTHER CLASSROOMS WITH LOOSE SEATING TO BE PROVIDED WITH FFBE REFERRED SUBMITTA FOR APPROVAL.
- WHERE SINKS ARE PROVIDED IN ACCESSIBLE SPACES, AT LEAST 5%, BUT NOT LESS THAN ONE OF EACH TYPE, MUST BE ACCESSIBLE PER IBC 119-212.3, 2010 STANDARDS 712.3. A 30" MINIMUM CLEAR FLOOR SPACE, POSITIONED FOR FORWARD APPROACH WITH KNEE AND TOE CLEARANCE IS REQUIRED AT A SINK. (ICC 118-606.2, 2010 STANDARDS 603.2).
- WHERE SEATING OR STANDING SPACE AT TABLES, COUNTERS OR WORK SURFACES IS PROVIDED IN ACCESSIBLE SPACES, AT LEAST 5 PERCENT OF THE SEATING AND STANDING SPACES, BUT NOT LESS THAN ONE, MUST BE ACCESSIBLE. (ICC 118-226.1)

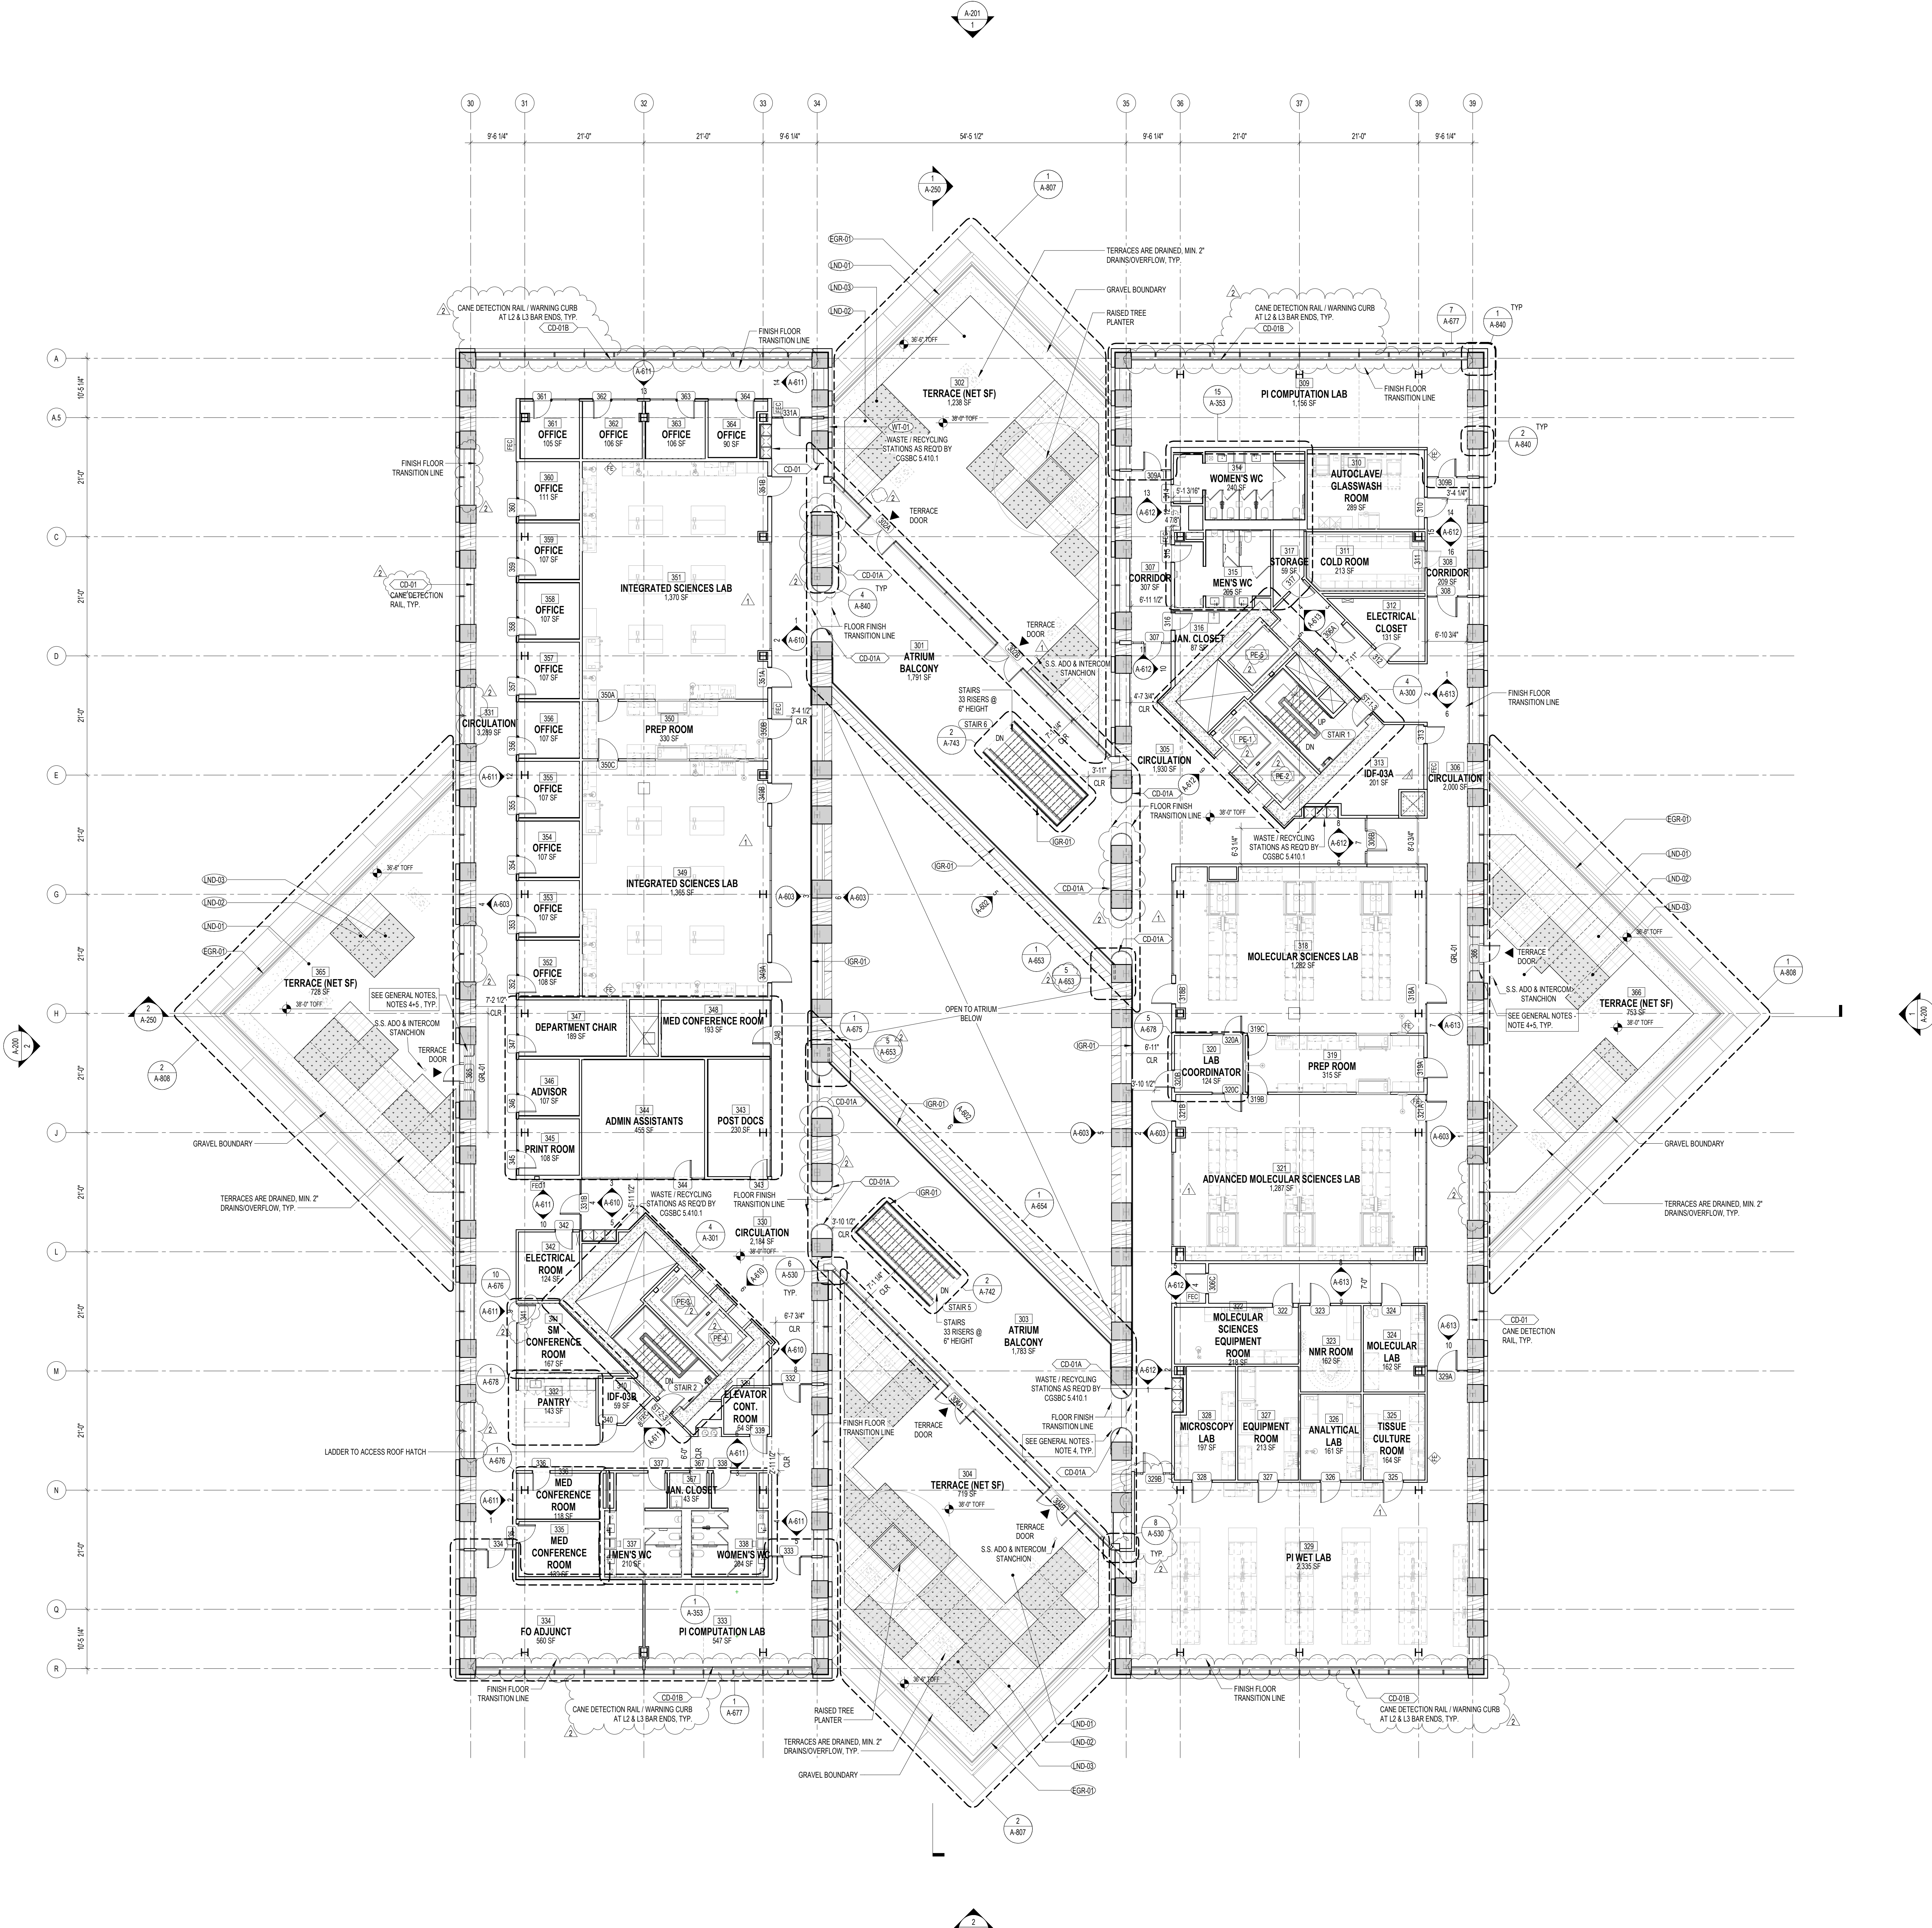


1 LEVEL 3 FLOOR PLAN
 A-103
 3/27 - 11/17

LEVEL 3 FLOOR PLAN

A-103

CONSTRUCTION LEGEND

- TERRACE NON-PAVED AREA
- TERRACE PLANTING AREA
- GRAVEL AREA
- CONCRETE PAVERS
- REMOVABLE WALK-OFF MAT
- FULL HEIGHT INTERIOR GLASS PARTITION
- FULL HEIGHT GIB WALL
- CONCRETE MASONRY UNIT WALL
- UNITIZED CURTAIN WALL SYSTEM
- STOREFRONT SYSTEM
- INTERIOR GLAZED RAILINGS
- EXTERIOR MESH RAILINGS
- EXTERIOR METAL PICKET RAILINGS
- LOADING DOCK COOLING DOOR
- METAL FRAMED SKYLIGHT SYSTEM
- PHOTOVOLTAIC ROOF PANELS
- ROOF DRAIN AND OVERFLOW DRAIN

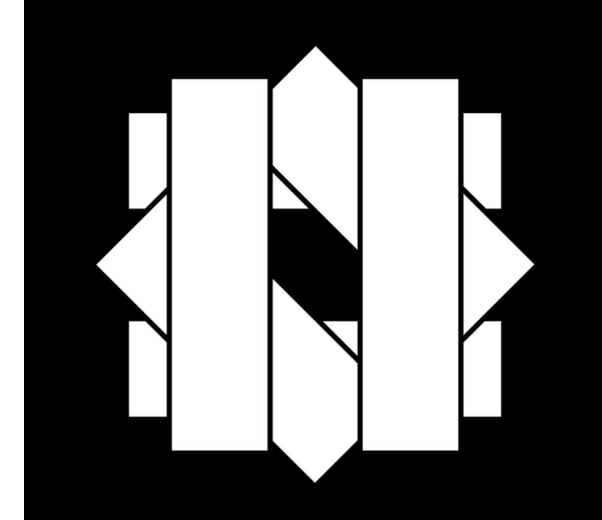

ROBERT DAY SCIENCES CENTER

CLAREMONT MCKENNA COLLEGE
 600 NORTH GARDEN BOULEVARD
 CLAREMONT, CA 91711, USA
 CLIENT
CLAREMONT MCKENNA COLLEGE
 600 NORTH STREET
 CLAREMONT, CA 91711, USA
 PROJECT NO. 2019-001
















GENERAL NOTES

1. FOR DETAILED TERRACE AND SITE LANDSCAPE PLANS REFER TO LANDSCAPE DRAWINGS.
2. ALL VISIBLE STRUCTURAL STEEL FRAMING MEMBERS TO BE FIREPROOFED WITH INTUMESCENT PAINT (SEE REPORT NO. 1078) OR ENCASED IN CONCRETE AS REQUIRED FOR TYPE 1B CONSTRUCTION.
3. SKYLIGHT AT ROOF LEVEL, SIZED TO BE LESS THAN 10% OF ROOF AREA TO COMPLY WITH ENERGY REQUIREMENTS. ACTUAL AREA AS SHOWN IN PLANS IS 3.1% OF ROOF AREA.
4. ALL AREAS AT LOW CLEARANCE ZONES LESS THAN 8'0" AND FLOOR HEIGHT TIGHTENINGS OF LESS THAN 3'0" TO BE PROVIDED WITH CANE RAILS FOR CANE DETECTION. REFER TO SHEET A-165 FOR CANE RAIL DETAILS. CANE RAILS TO BE CD-01 TYPICAL, UNLESS OTHERWISE NOTED AS CD-0A, FB-01 OR FB-02A.
5. SEE SHEET A-375 FOR TYPICAL ENTRY WALK OFF MAT PLANS AND DETAILS.
6. ALL CLASSROOMS/INSTRUCTIONAL ASSEMBLY SPACES TO BE PROVIDED WITH A PERMANENTLY INSTALLED ASSISTIVE LISTENING SYSTEM. MINIMUM NUMBER OF RECEIVERS TO BE PROVIDED SHALL BE 4% OF THE TOTAL NUMBER OF SEATS PER 2019 IBC 109.2.19. REFER TO A-800 FOR LARGE SEMINAR ROOM #200 FOR DEVICE QUANTITY. NUMBER OF RECEIVERS IN ALL OTHER CLASSROOMS WITH LOOSE SEATING TO BE PROVIDED WITH FFBE REFERRED SUBMITTA FOR APPROVAL.
7. WHERE SINKS ARE PROVIDED IN ACCESSIBLE SPACES, AT LEAST 5%, BUT NOT LESS THAN ONE OF EACH TYPE, MUST BE ACCESSIBLE PER IBC 119-203.3, 2010 STANDARDS 703.3. A 30" MINIMUM CLEAR FLOOR SPACE, POSITIONED FOR FORWARD APPROACH WITH KNEE AND TOE CLEARANCE IS REQUIRED AT A SINK. (IBC 119-206.2, 2010 STANDARDS 603.2)
8. WHERE SEATING OR STANDING SPACE AT TABLES, COUNTERS OR WORK SURFACES IS PROVIDED IN ACCESSIBLE SPACES, AT LEAST 5 PERCENT OF THE SEATING AND STANDING SPACES, BUT NOT LESS THAN ONE, MUST BE ACCESSIBLE. (IBC 119-226.1)


NO.	DATE	ISSUE
1	05-29-2024	BULLETIN 4
2	10-23-2023	BULLETIN 2
3	03-17-2023	ISSUED FOR CONSTRUCTION
4	12-16-2022	50% CONSTRUCTION DOCUMENTS
5	09-19-2022	PLAN CHECK SUBMISSION
6	05-13-2022	PLAN CHECK / 50% DESIGN DEVELOPMENT
7	03-02-2022	100% SCHEMATIC DESIGN
8	01-26-2022	50% SCHEMATIC DESIGN

THESE DRAWINGS ARE INSTRUMENTS OF SERVICE AND MAY NOT BE USED FOR OTHER PROJECTS, FOR ADDITIONS TO THIS PROJECT OR COMPLETION OF THIS PROJECT BY OTHERS.

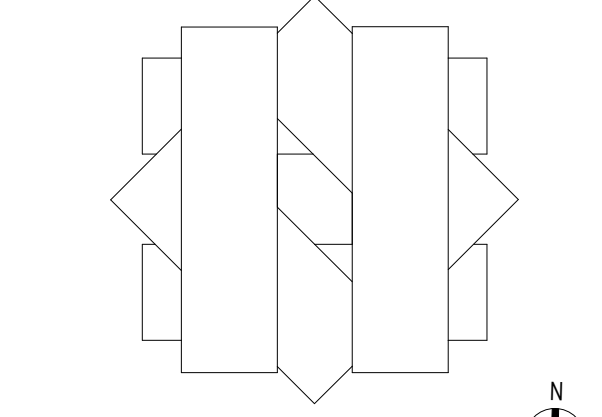

ROOF LEVEL FLOOR PLAN

PROJECT NUMBER: SHEET NUMBER
 2019
 DRAW NUMBER
 SCALE: As Indicated
 DATE: 05/29/2024
 ARCH: E

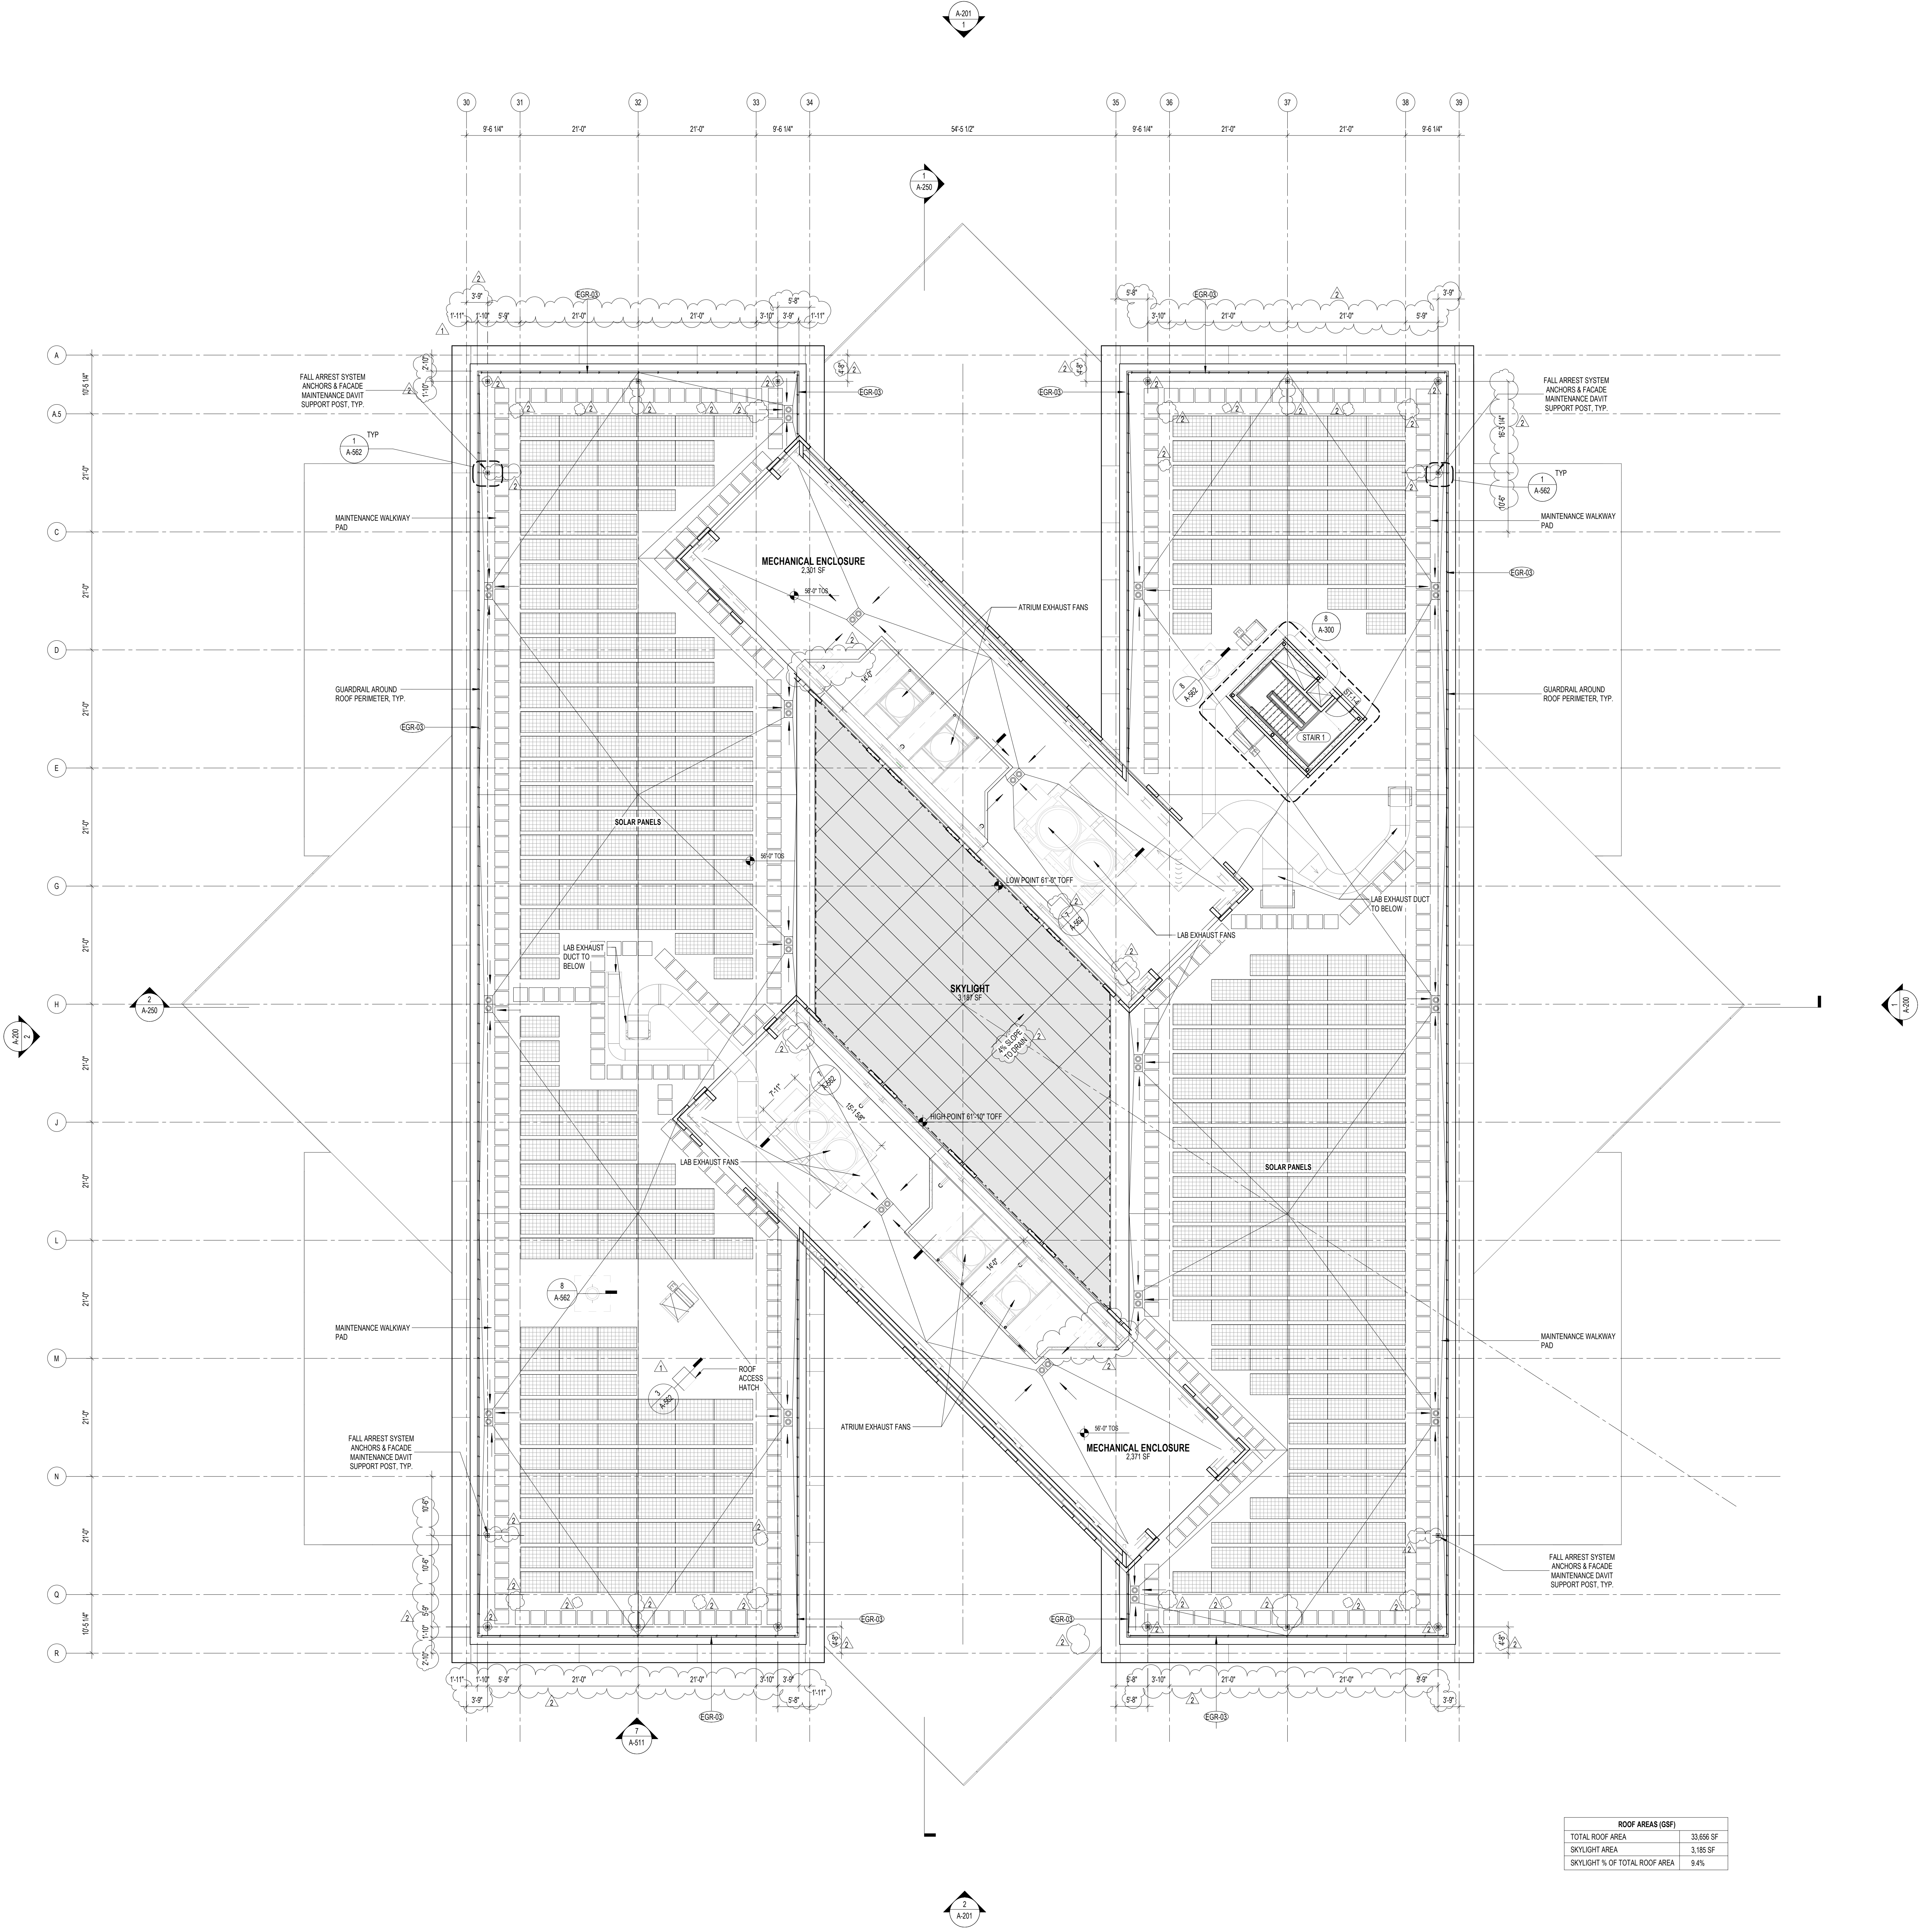

ROOF AREAS (GSF)	
TOTAL ROOF AREA	33,696 SF

1 ROOF LEVEL FLOOR PLAN
 A-104
 3/2" = 1'-0"